

* 6" Cabinet Soffits
 Ceiling Ht: 91"
 Basement finished
 Panel Box full tw/dbls


DRAWINGS PROVIDED BY:
GREAT SPACES, INC.
 245 ARLINGTON STREET
 ACTON, MA 01720

PERSPECTIVE VIEWS ARE FOR OVERALL DESIGN RENDITION;
 COLORS, TILE PATTERN, FIXTURES, ACCESSORIES, ETC. MAY NOT
 BE DEPICTED AS ACTUAL ITEMS PURCHASED

PROJECT DESCRIPTION:
MALAKIAN RESIDENCE
 184 Littlefield Rd Boxborough 01719

PHASE 1 DESIGN:
AS BUILT

DESIGNER:	SCALE:	DATE:
KA	1/2"	2/24/2022

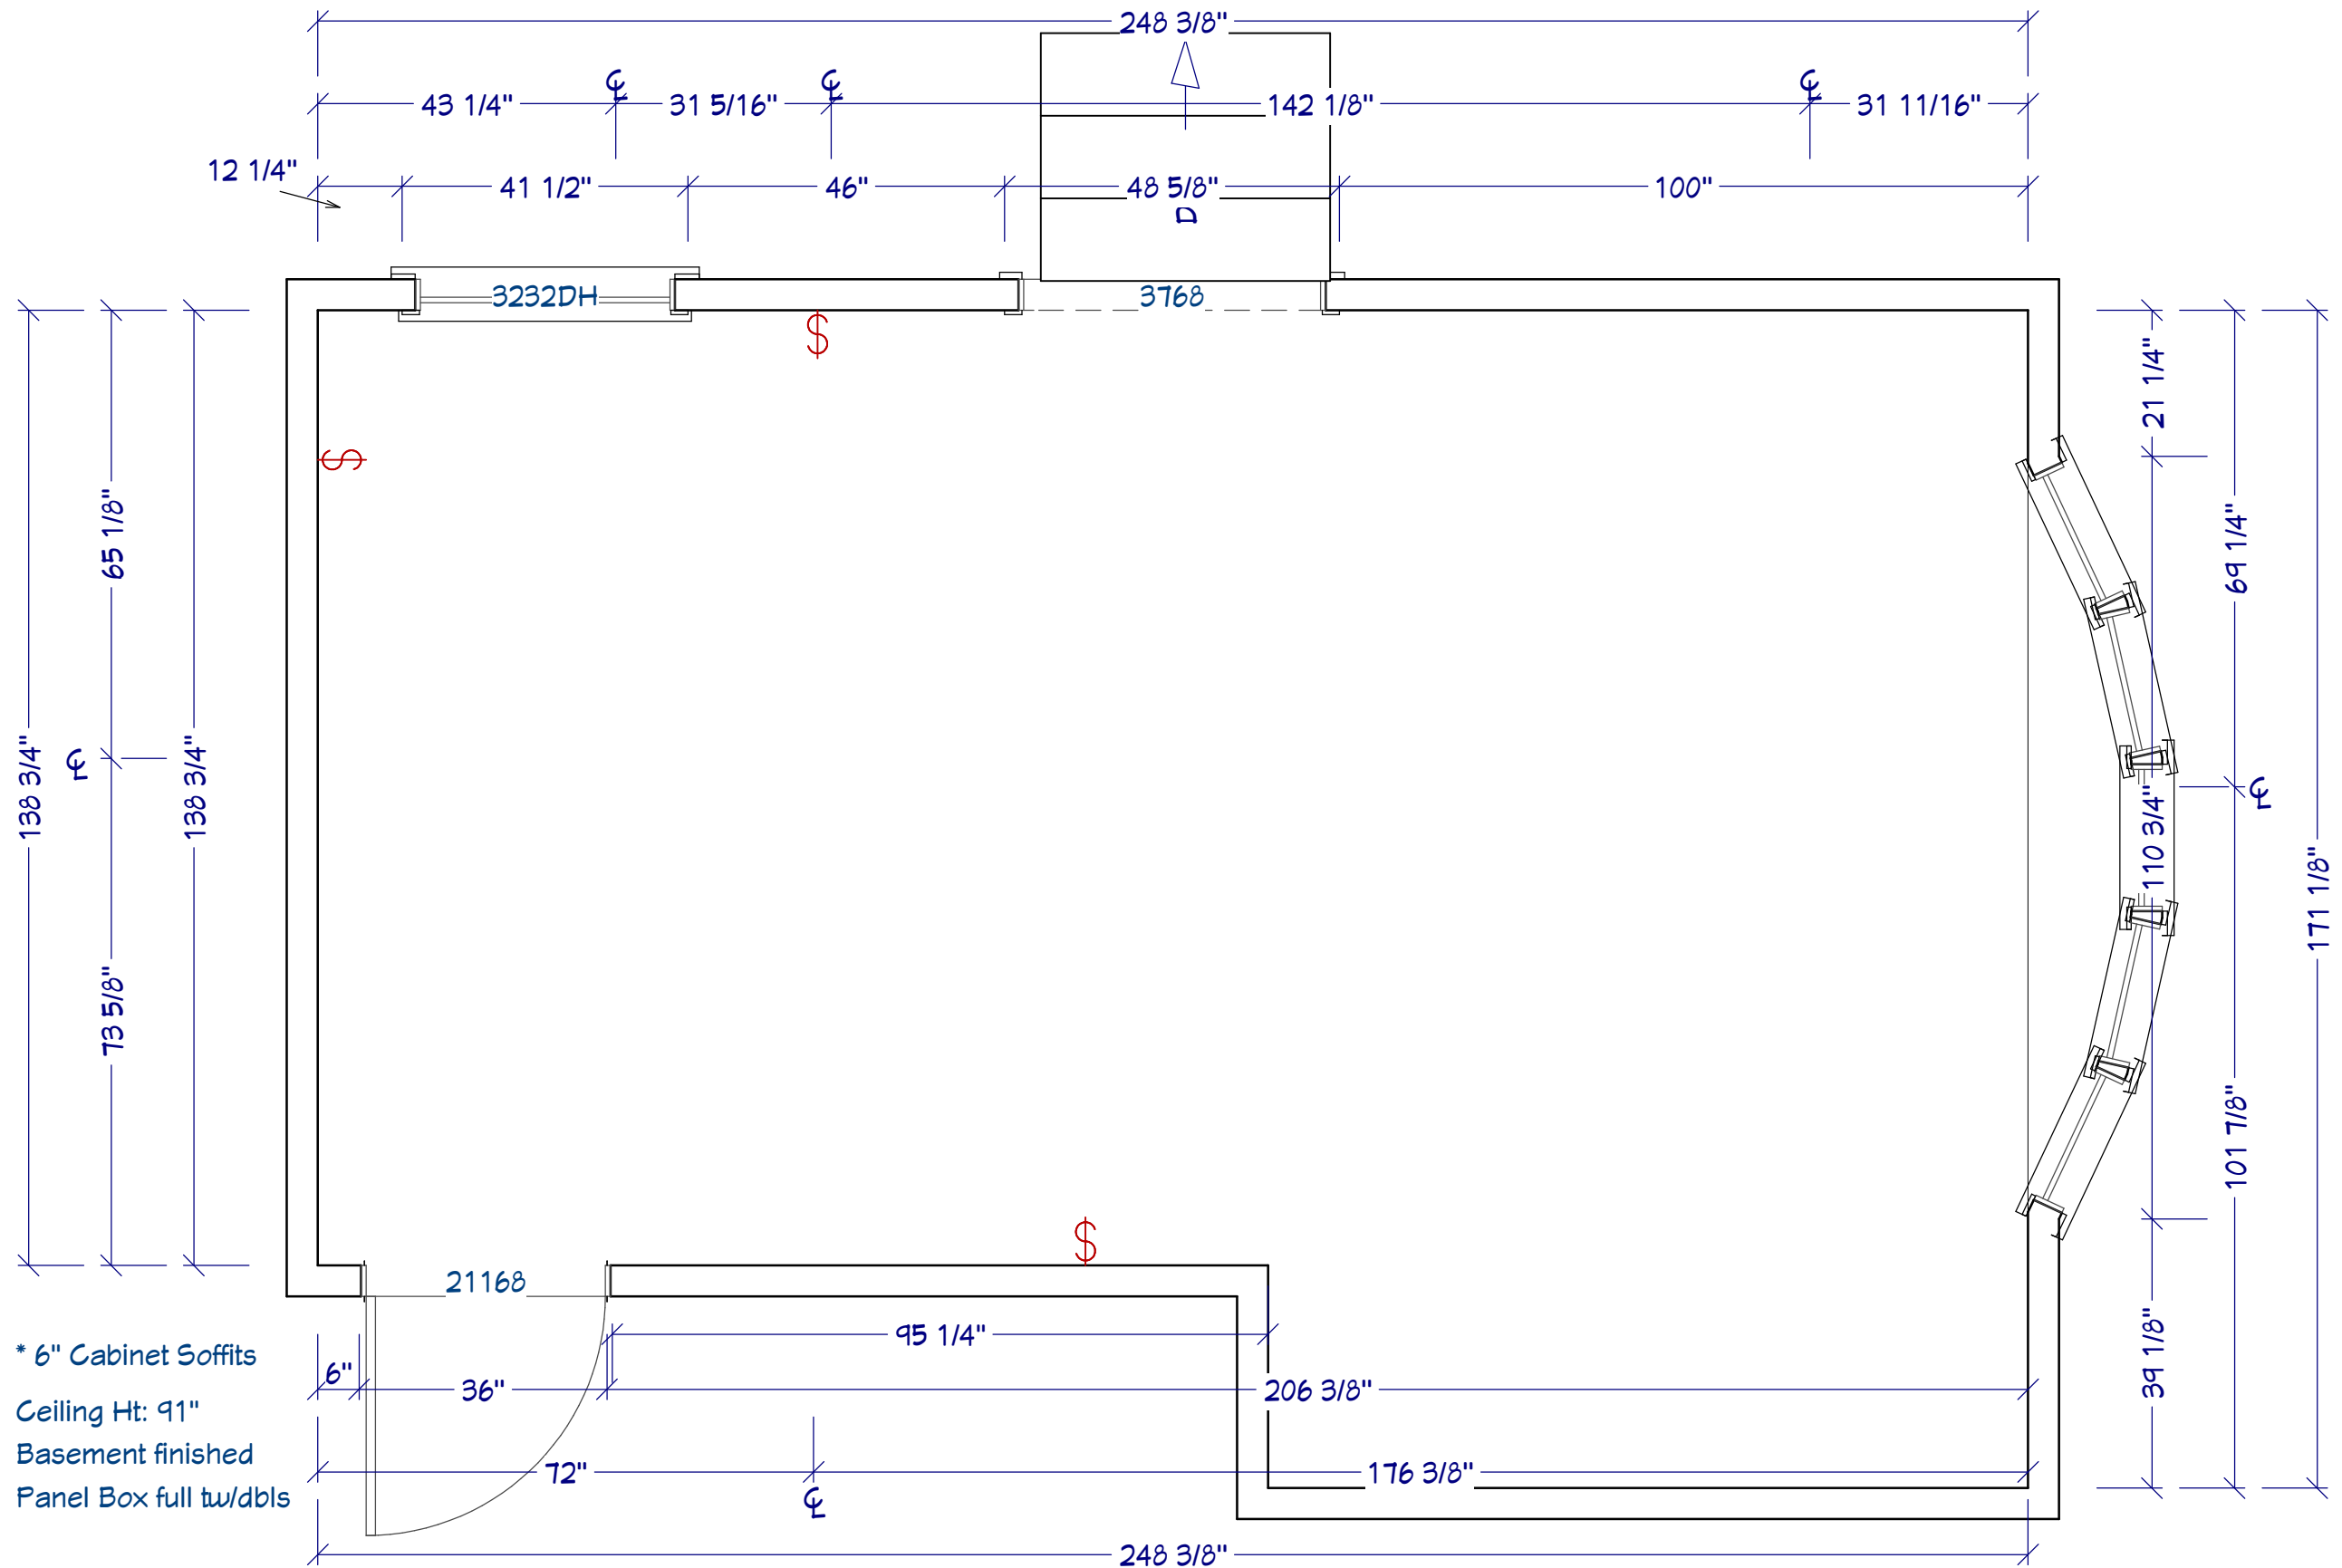

* 6" Cabinet Soffits
 Ceiling Ht: 91"
 Basement finished
 Panel Box full tw/dbls


DRAWINGS PROVIDED BY:
GREAT SPACES, INC.
 245 ARLINGTON STREET
 ACTON, MA 01720

PERSPECTIVE VIEWS ARE FOR OVERALL DESIGN RENDITION;
 COLORS, TILE PATTERN, FIXTURES, ACCESSORIES, ETC. MAY NOT
 BE DEPICTED AS ACTUAL ITEMS PURCHASED

PROJECT DESCRIPTION:
MALAKIAN RESIDENCE
 184 Littlefield Rd Boxborough 01719

PHASE 1 DESIGN:

DESIGNER:	SCALE:	DATE:
KA	1/2"	2/24/2022

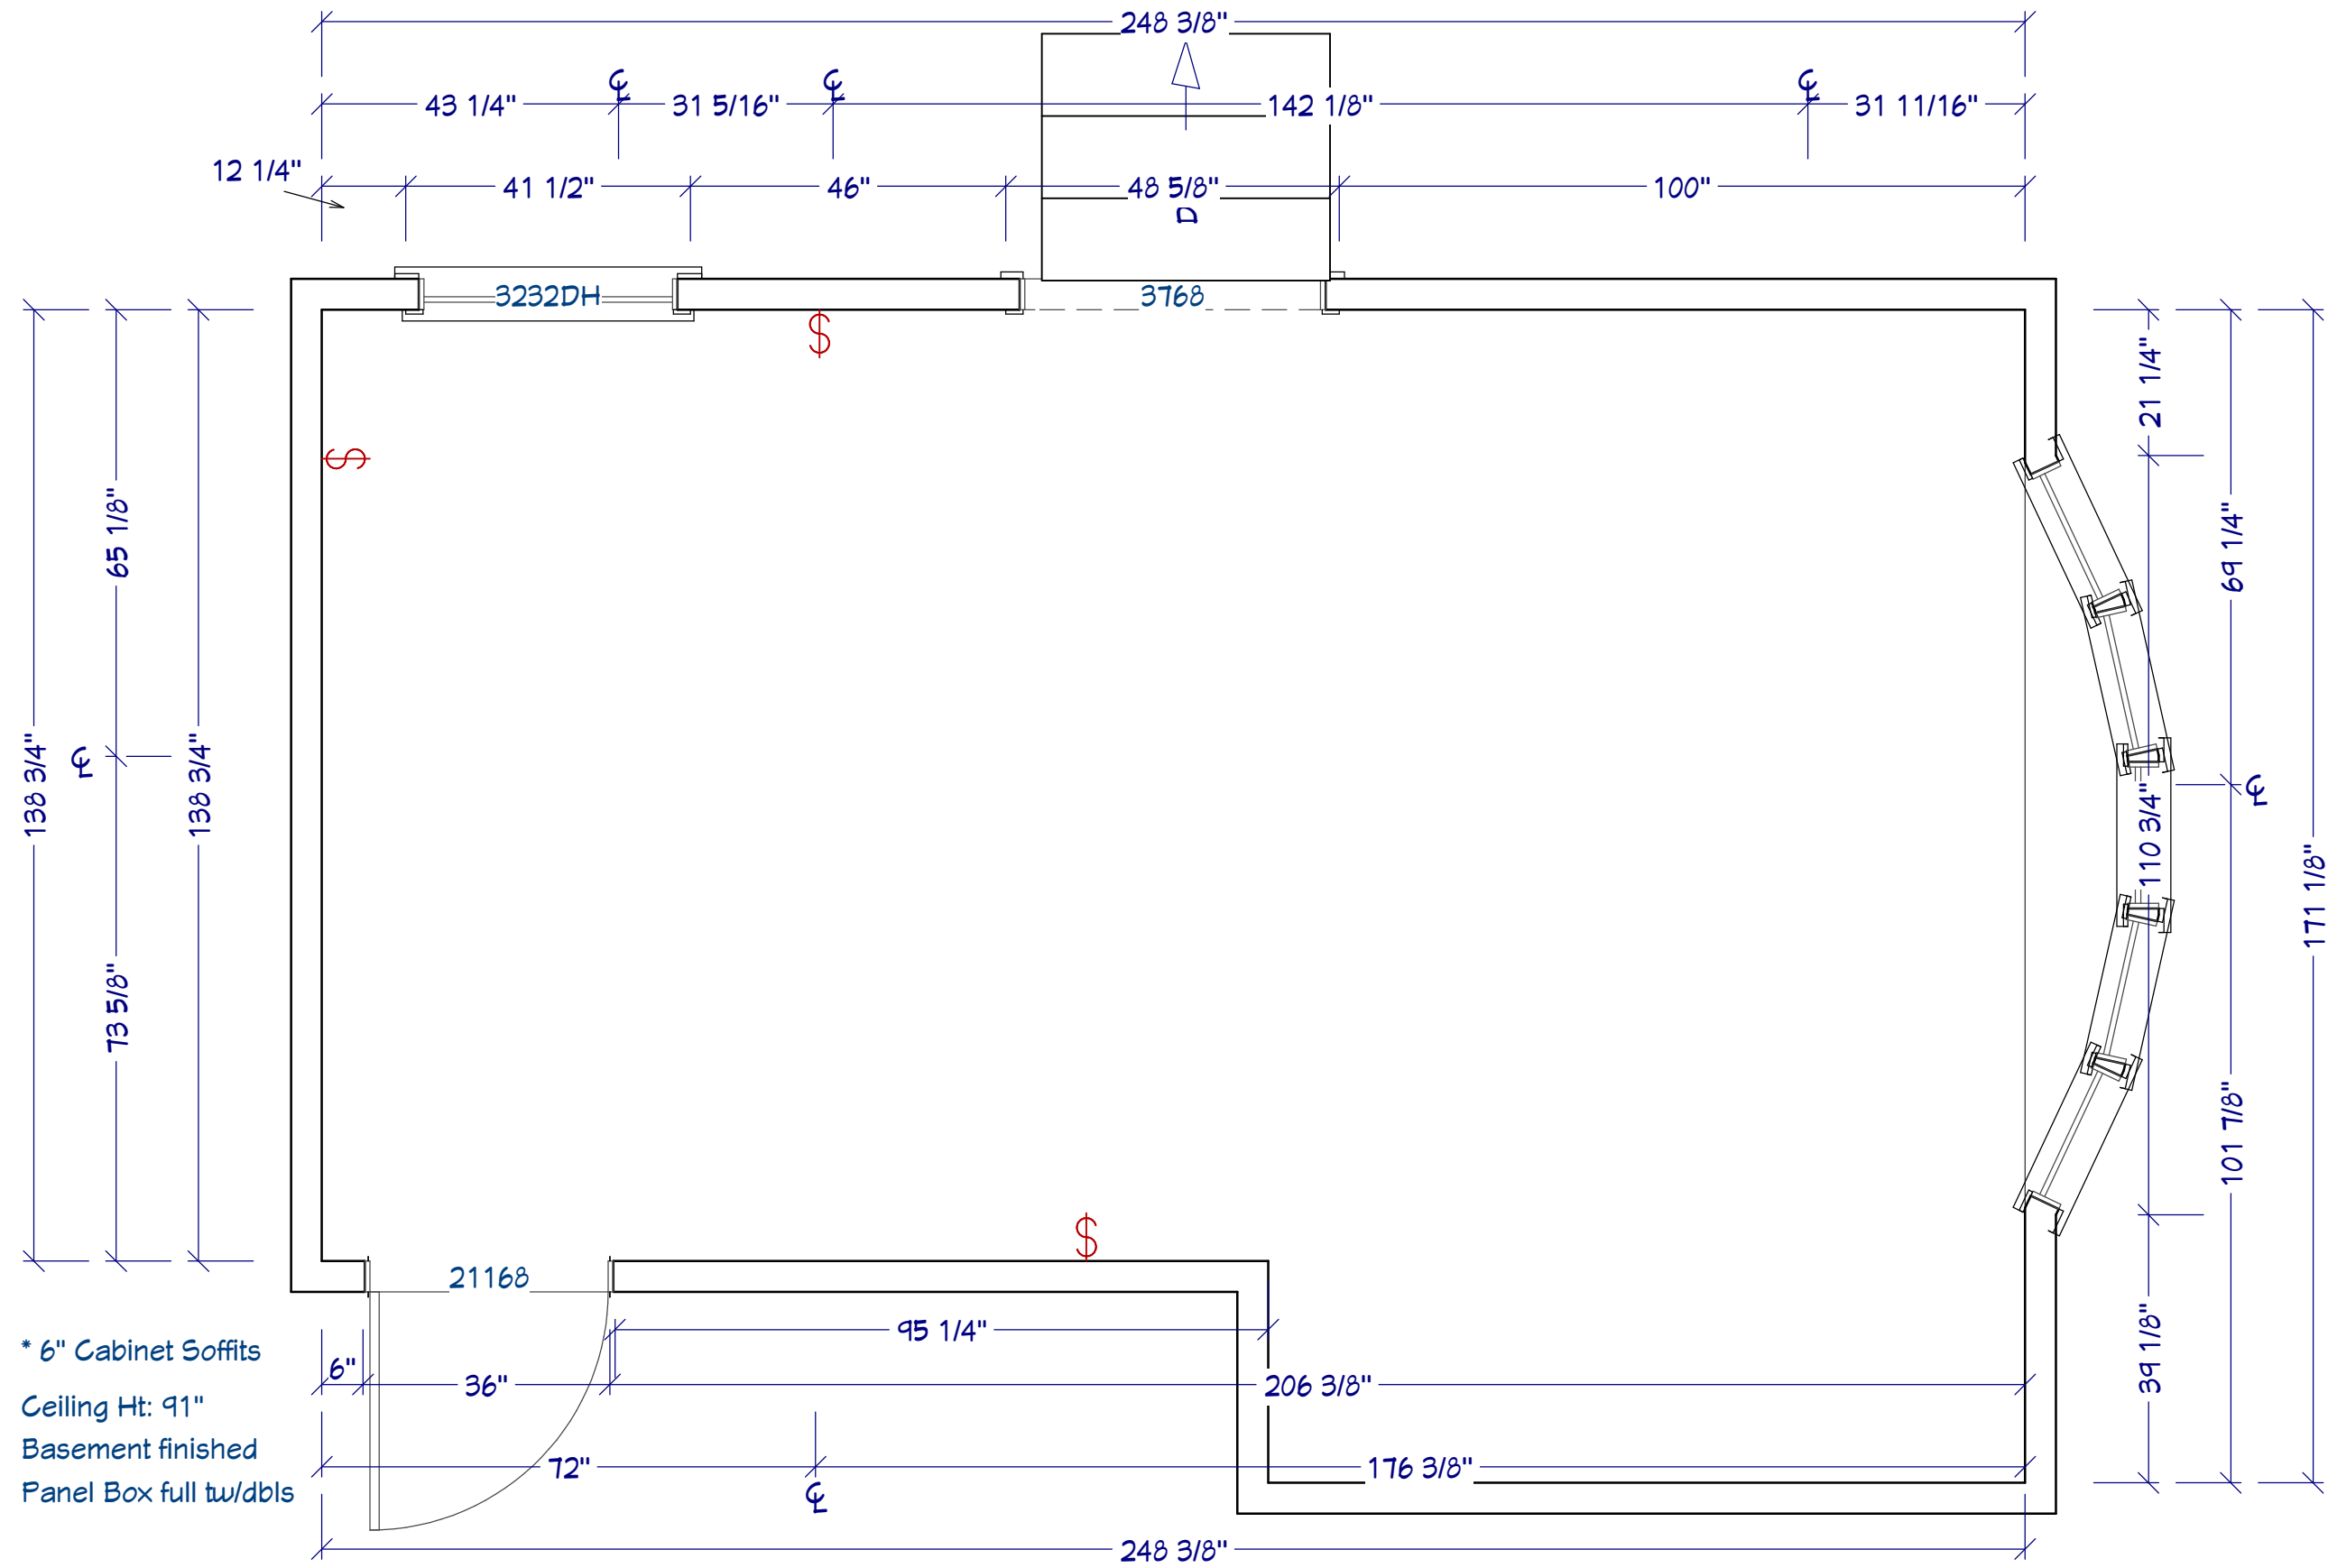

* 6" Cabinet Soffits
 Ceiling Ht: 91"
 Basement finished
 Panel Box full tw/dbls


DRAWINGS PROVIDED BY:
GREAT SPACES, INC.
 245 ARLINGTON STREET
 ACTON, MA 01720

PERSPECTIVE VIEWS ARE FOR OVERALL DESIGN RENDITION;
 COLORS, TILE PATTERN, FIXTURES, ACCESSORIES, ETC. MAY NOT
 BE DEPICTED AS ACTUAL ITEMS PURCHASED

PROJECT DESCRIPTION:
MALAKIAN RESIDENCE
 184 Littlefield Rd Boxborough 01719

PHASE 1 DESIGN:

DESIGNER:	SCALE:	DATE:
KA	1/2"	2/24/2022

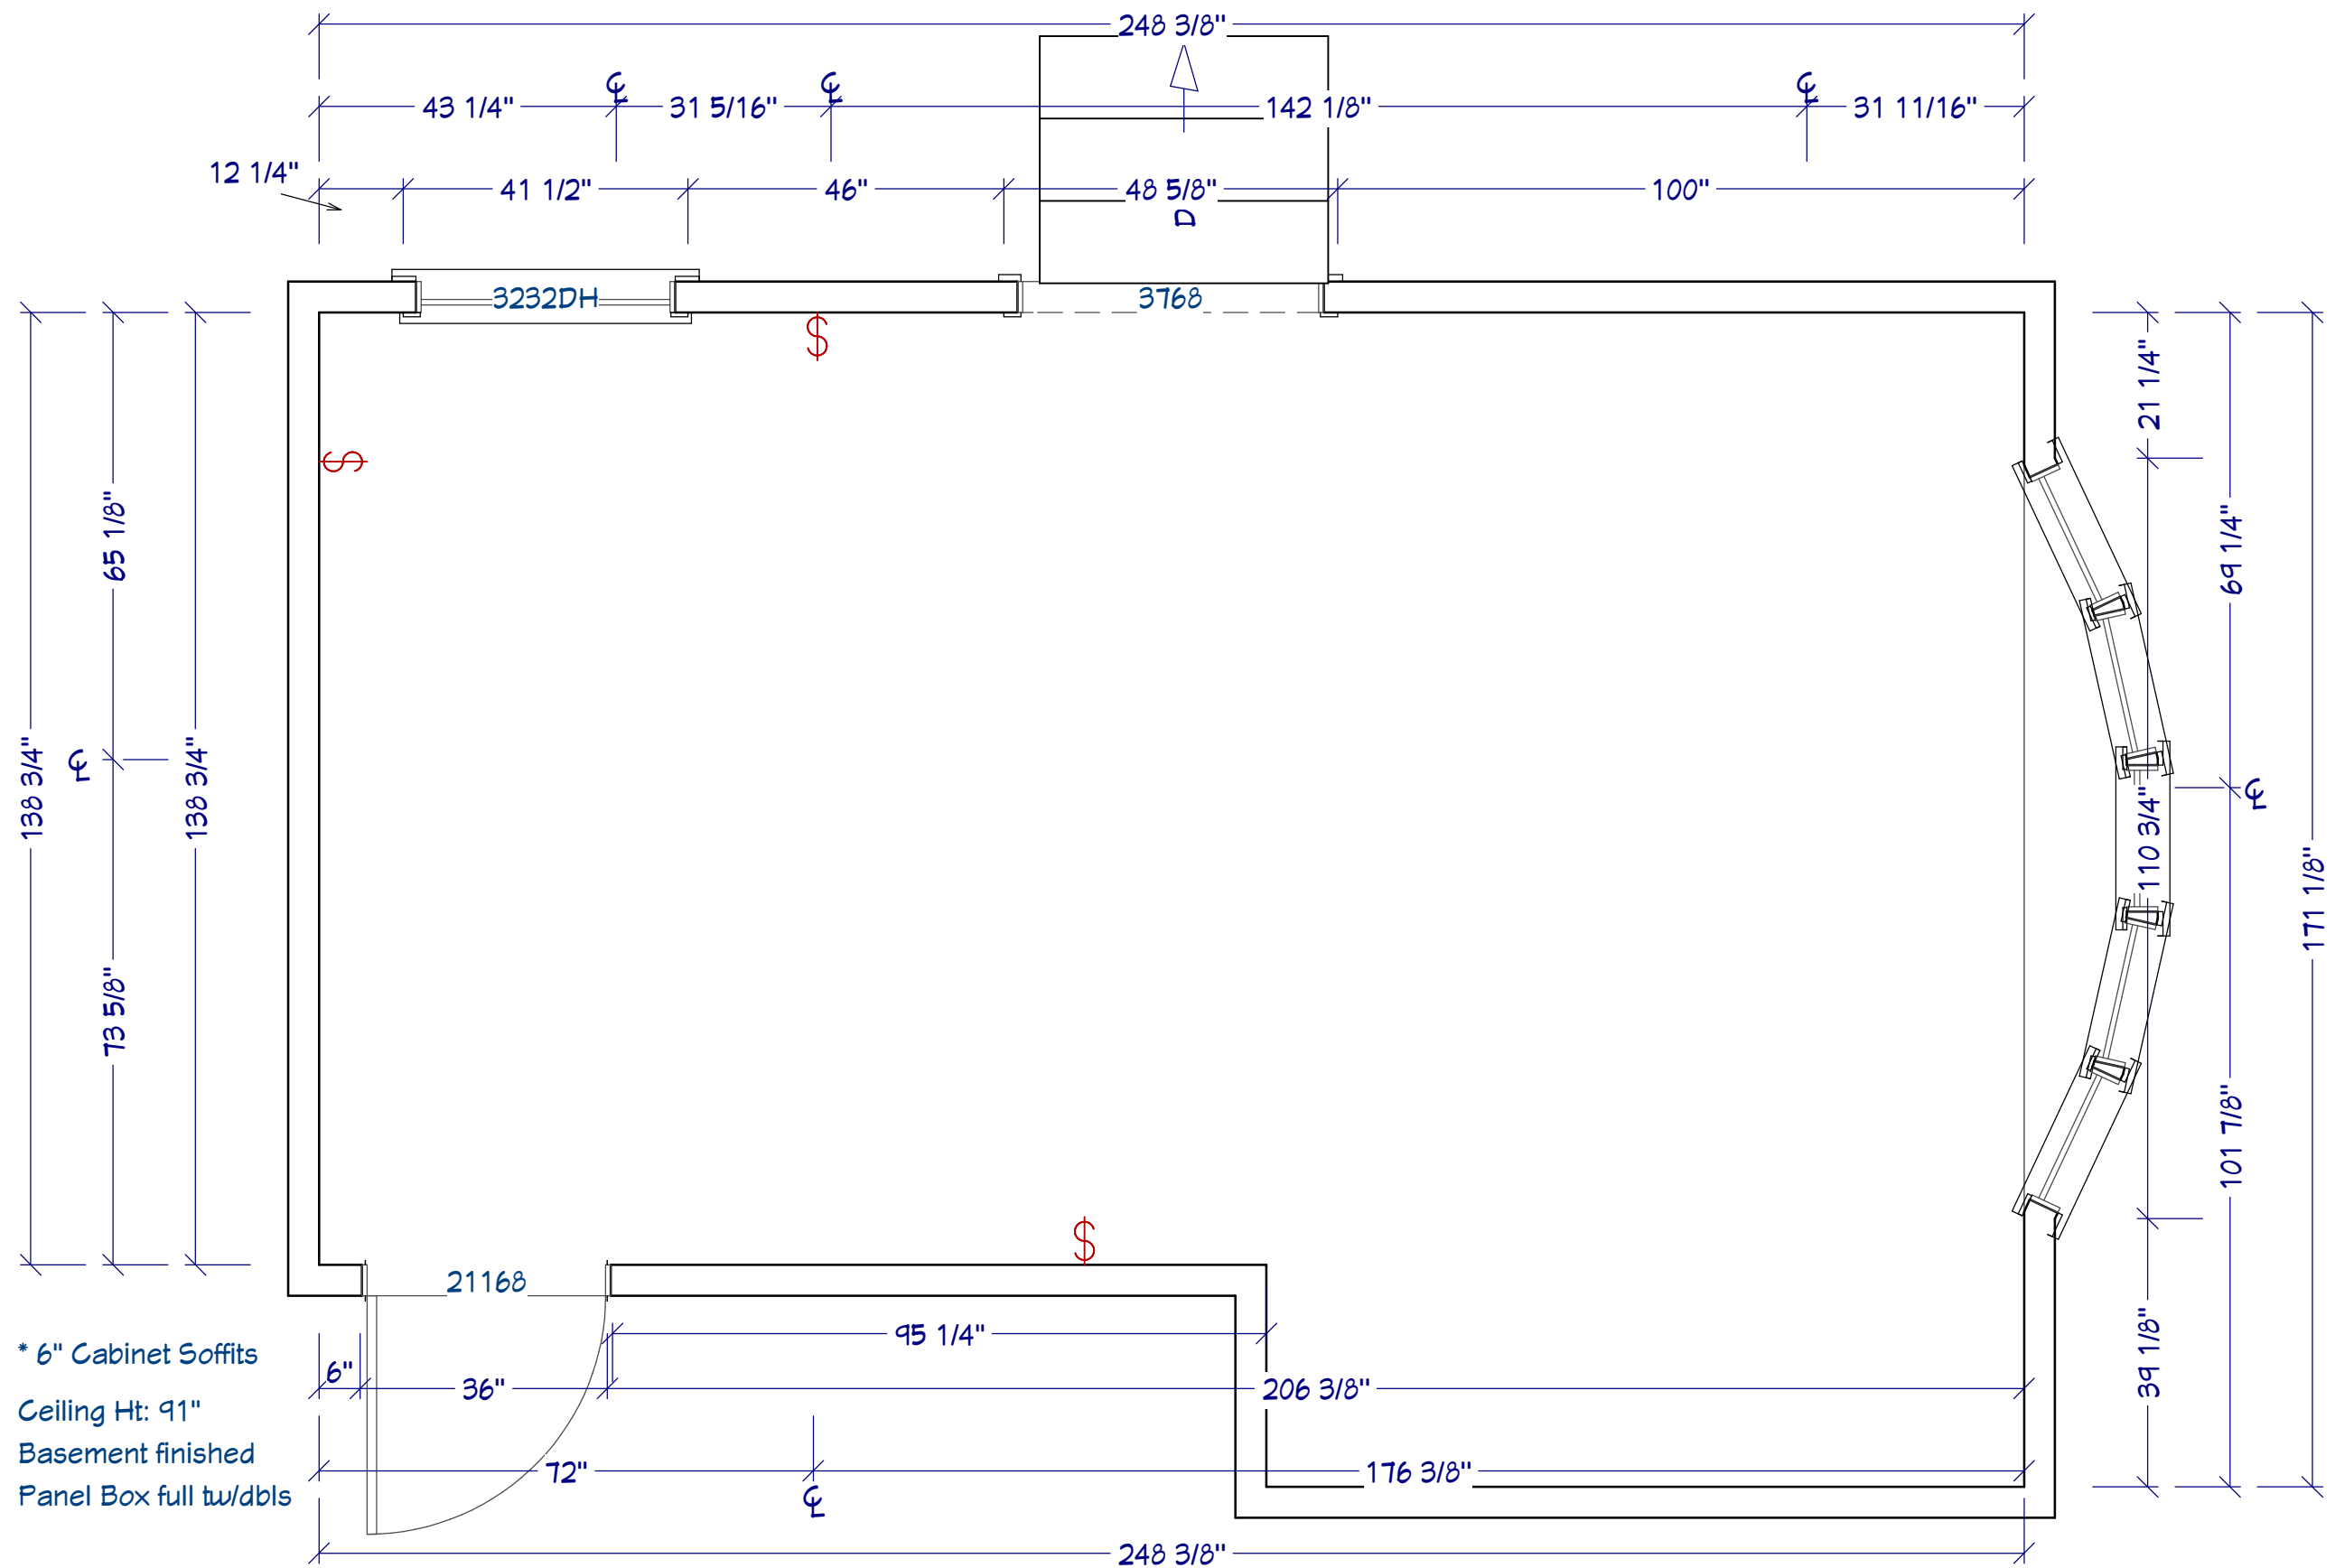

* 6" Cabinet Soffits
 Ceiling Ht: 91"
 Basement finished
 Panel Box full tw/dbls

DRAWINGS PROVIDED BY:
GREAT SPACES, INC.
 245 ARLINGTON STREET
 ACTON, MA 01720

PERSPECTIVE VIEWS ARE FOR OVERALL DESIGN RENDITION;
 COLORS, TILE PATTERN, FIXTURES, ACCESSORIES, ETC. MAY NOT
 BE DEPICTED AS ACTUAL ITEMS PURCHASED

PROJECT DESCRIPTION:
MALAKIAN RESIDENCE
 184 Littlefield Rd Boxborough 01719

PHASE 1 DESIGN:

DESIGNER:	SCALE:	DATE:
KA	1/2"	2/24/2022