


DRAWINGS PROVIDED BY:
GREAT SPACES, INC.
 245 ARLINGTON STREET
 ACTON, MA 01720

PERSPECTIVE VIEWS ARE FOR OVERALL DESIGN RENDITION;
 COLORS, TILE PATTERN, FIXTURES, ACCESSORIES, ETC. MAY NOT
 BE DEPICTED AS ACTUAL ITEMS PURCHASED

PROJECT DESCRIPTION:
COLLINS RESIDENCE
 55 Highland St Concord 01742

PHASE 1 DESIGN:

DESIGNER:	SCALE:	DATE:
KA		3/23/2022

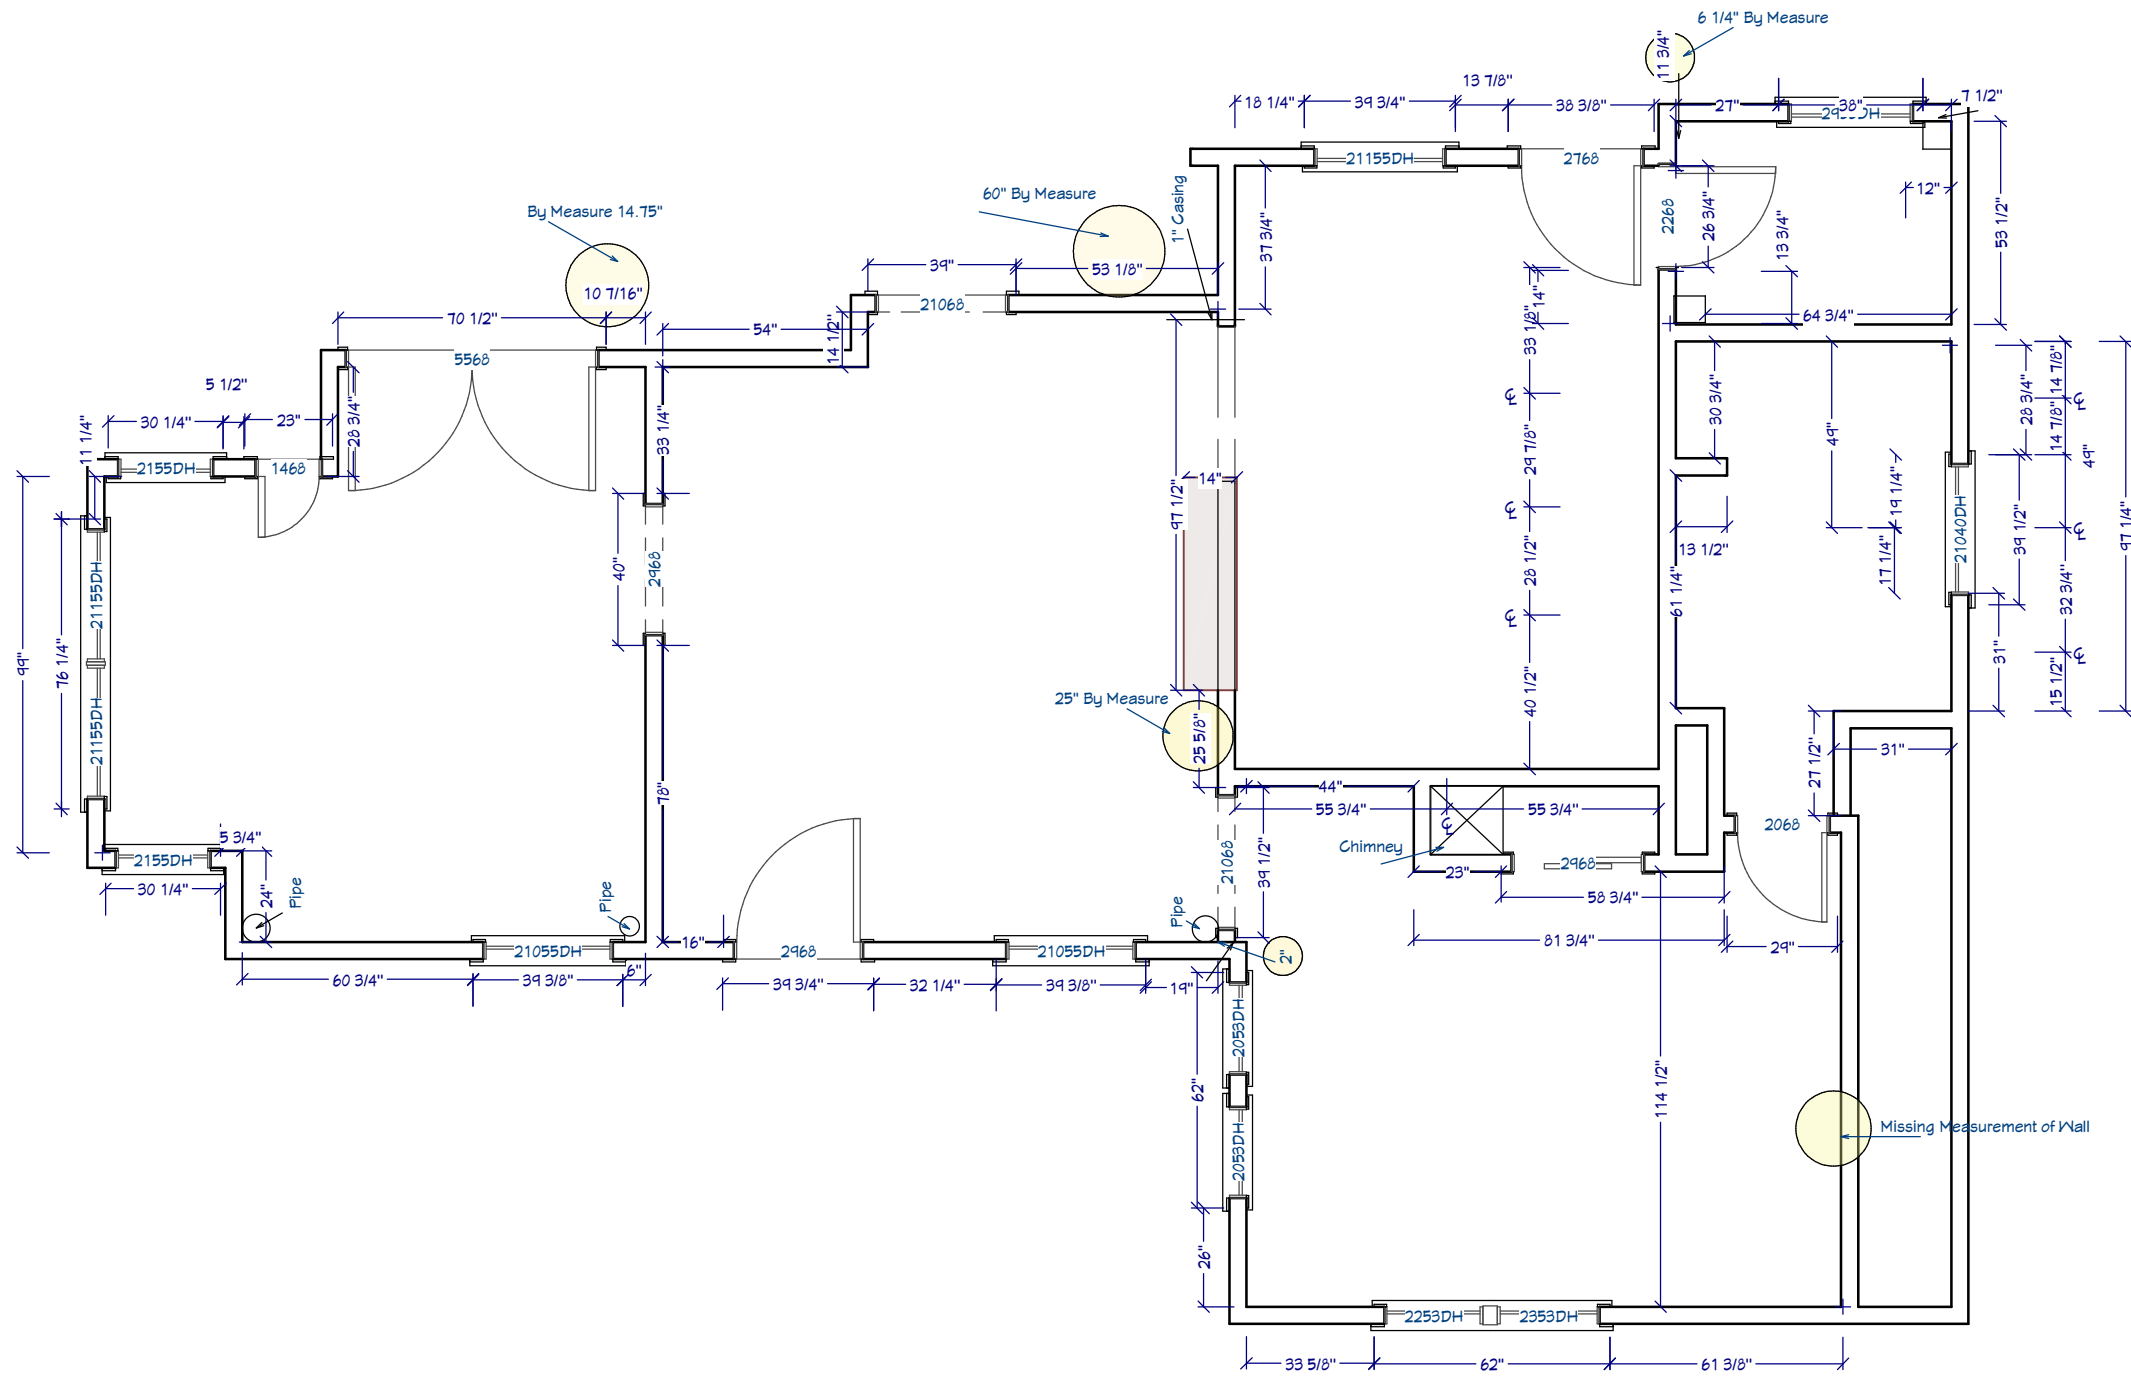


DRAWINGS PROVIDED BY:
GREAT SPACES, INC.
 245 ARLINGTON STREET
 ACTON, MA 01720

PERSPECTIVE VIEWS ARE FOR OVERALL DESIGN RENDITION;
 COLORS, TILE PATTERN, FIXTURES, ACCESSORIES, ETC. MAY NOT
 BE DEPICTED AS ACTUAL ITEMS PURCHASED

PROJECT DESCRIPTION:
COLLINS RESIDENCE
 55 Highland St Concord 01742

PHASE 1 DESIGN:

DESIGNER:	SCALE:	DATE:
KA		3/23/2022

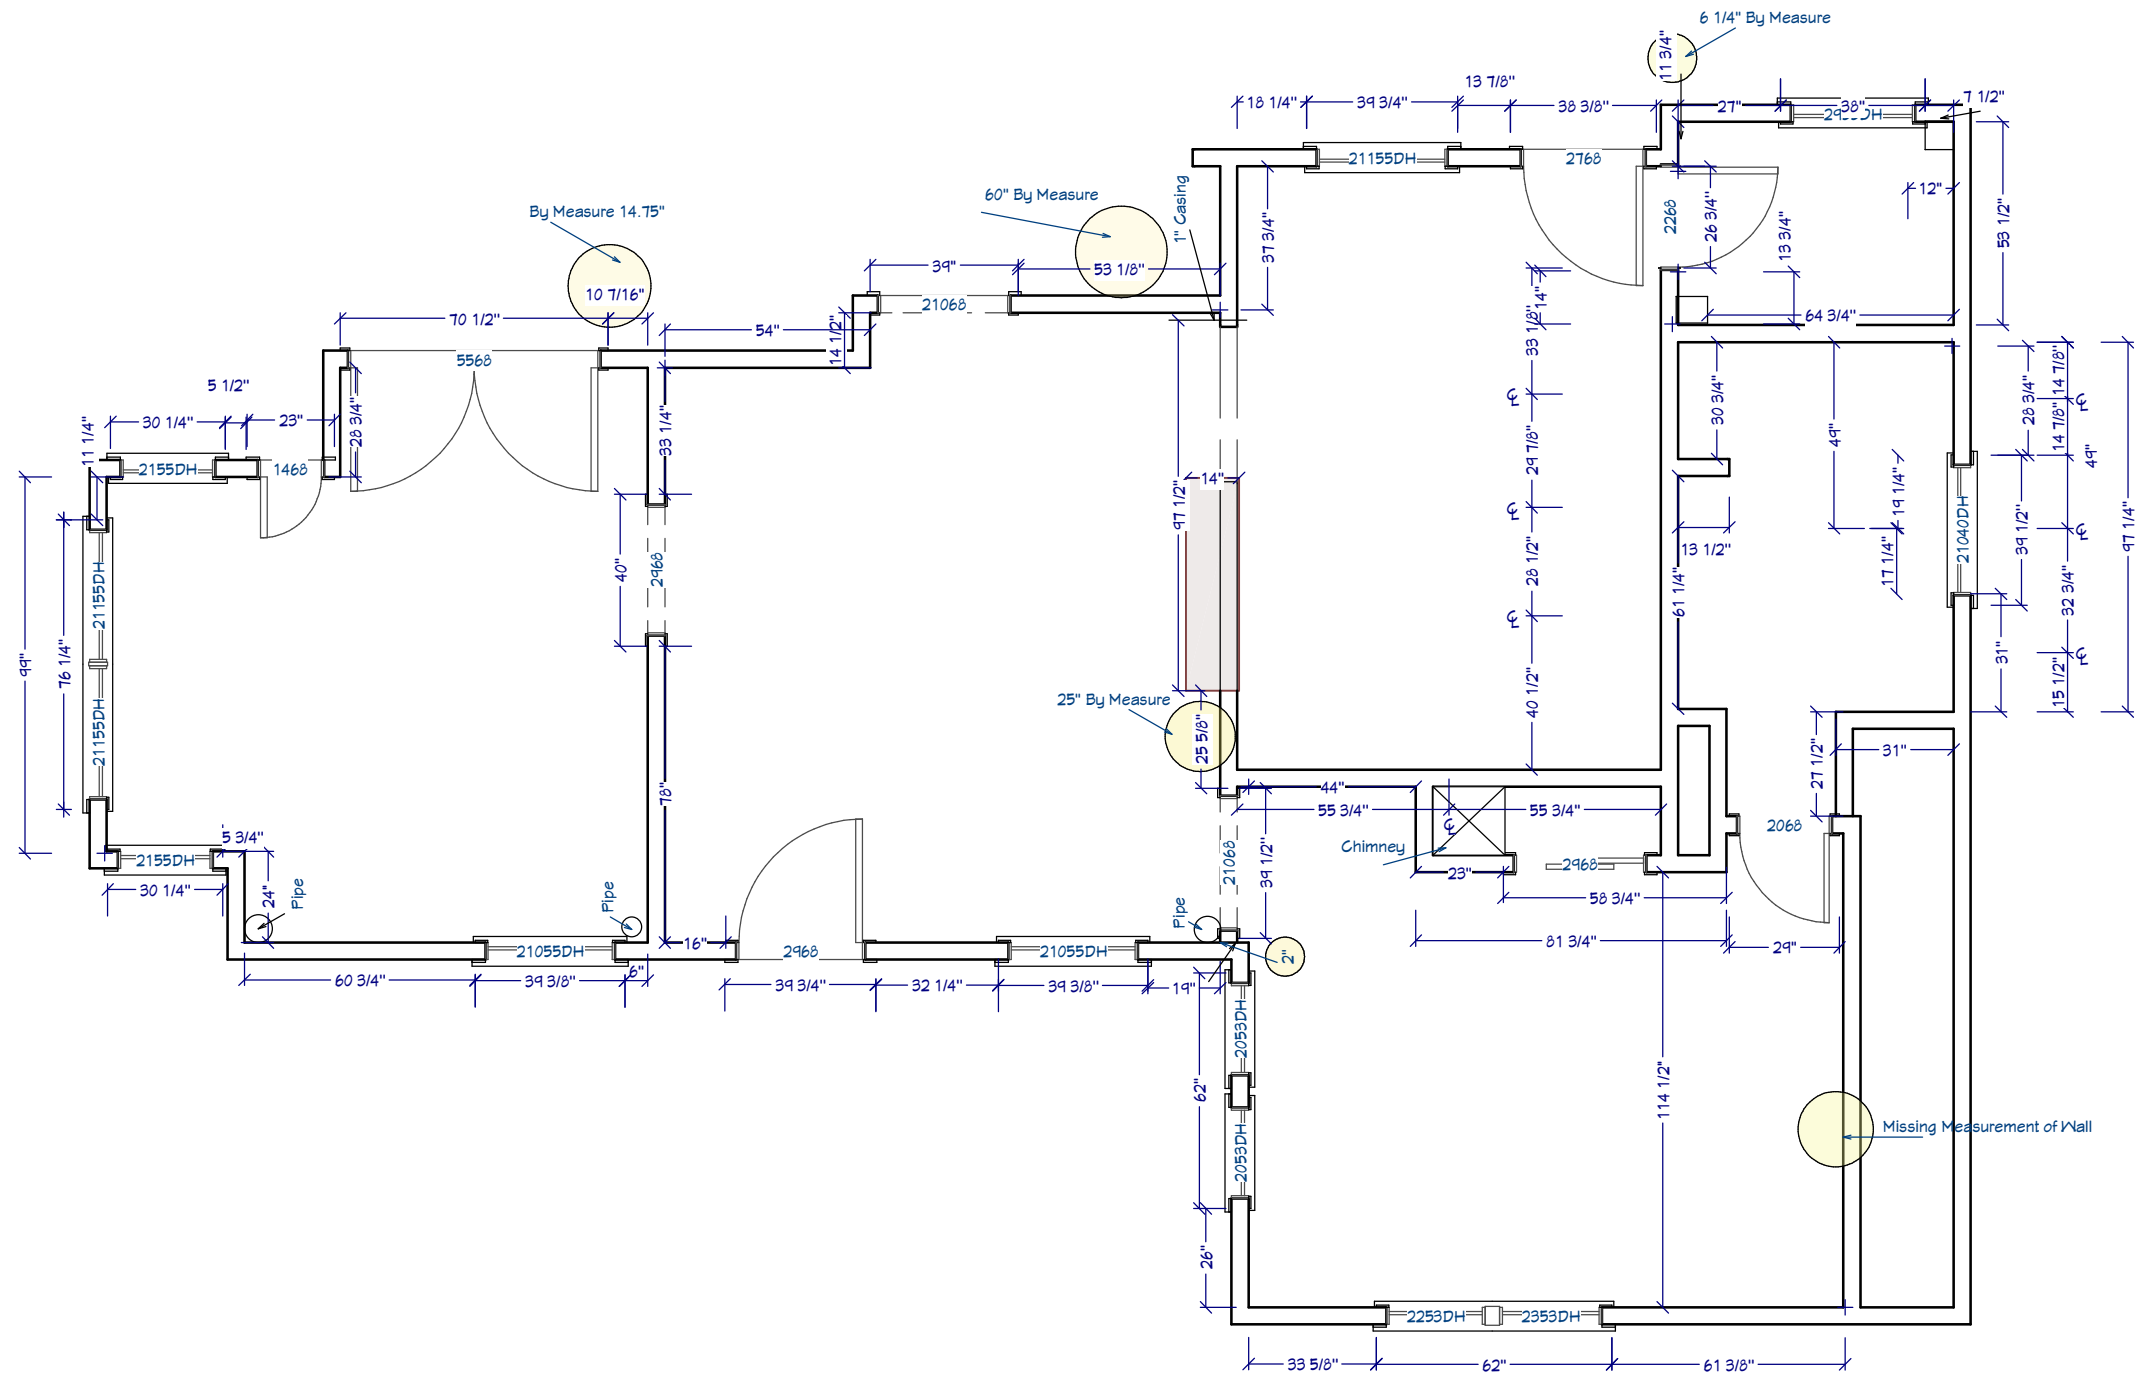

DRAWINGS PROVIDED BY:
GREAT SPACES, INC.
 245 ARLINGTON STREET
 ACTON, MA 01720

PERSPECTIVE VIEWS ARE FOR OVERALL DESIGN RENDITION;
 COLORS, TILE PATTERN, FIXTURES, ACCESSORIES, ETC. MAY NOT
 BE DEPICTED AS ACTUAL ITEMS PURCHASED

PROJECT DESCRIPTION:
COLLINS RESIDENCE
 55 Highland St Concord 01742

PHASE 1 DESIGN:

DESIGNER:	SCALE:	DATE:
KA		3/23/2022