


# MINSKY HOME RENOVATION

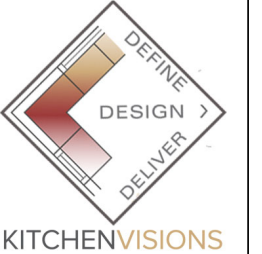

KITCHENVISIONS



## ASBUILT 1st FLOOR

NOTE: THIS DRAWING IS AN ARTISTIC INTERPRETATION OF THE GENERAL APPEARANCE OF THE DESIGN. IT IS NOT MEANT TO BE AN EXACT DESIGN. ALL MEASURES TO BE VERIFIED ON SITE.

KitchenVisions LLC and its representatives, do not warrant the sufficiency or use of this document for anyone other than KitchenVisions LLC. No one else may rely on this document in any manner. 2021 KitchenVisions LLC All rights reserved.

PROJECT:

DESCRIPTION:

DRAWINGS PROVIDED BY:  
DESIGNER: JODI SWARTZ CKBR DESIGNER:


DATE:

10/22/2022

1



KITCHENVISIONS

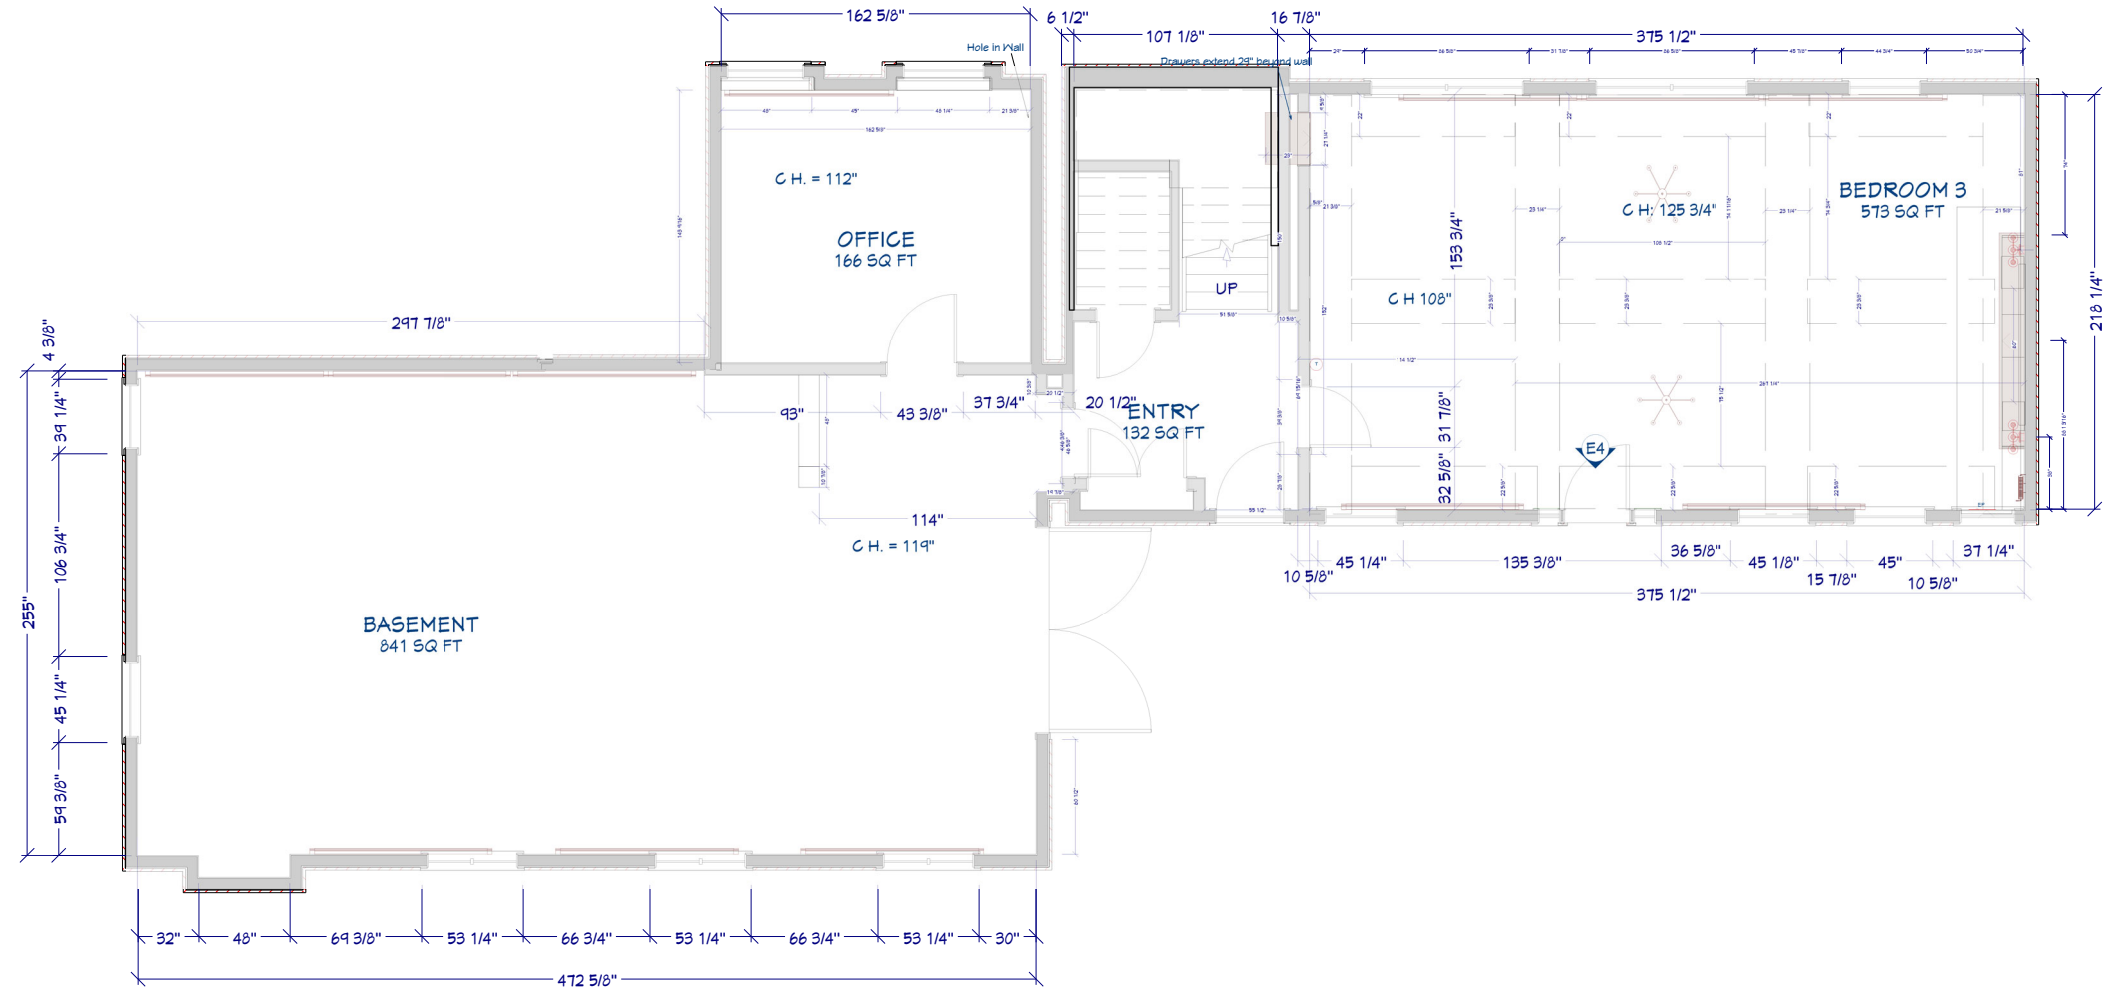

# ASBUILT BASEMENT

NOTE: THIS DRAWING IS AN ARTISTIC INTERPRETATION OF THE GENERAL APPEARANCE OF THE DESIGN. IT IS NOT MEANT TO BE AN EXACT DESIGN. ALL MEASURES TO BE VERIFIED ON SITE.

KitchenVisions LLC and its representatives, do not warrant the sufficiency or use of this document for anyone other than KitchenVisions LLC. No one else may rely on this document in any manner. 2021 KitchenVisions LLC All rights reserved.

PROJECT:

DESCRIPTION:

DRAWINGS PROVIDED BY:  
DESIGNER: JODI SWARTZ CKBR DESIGNER:

DATE:

10/22/2022